



NOTES:-
 1. USE FIGURED DIMENSIONS ONLY - DO NOT SCALE
 2. ALL DRAWINGS TO BE READ IN CONJUNCTION WITH THE SPECIFICATION

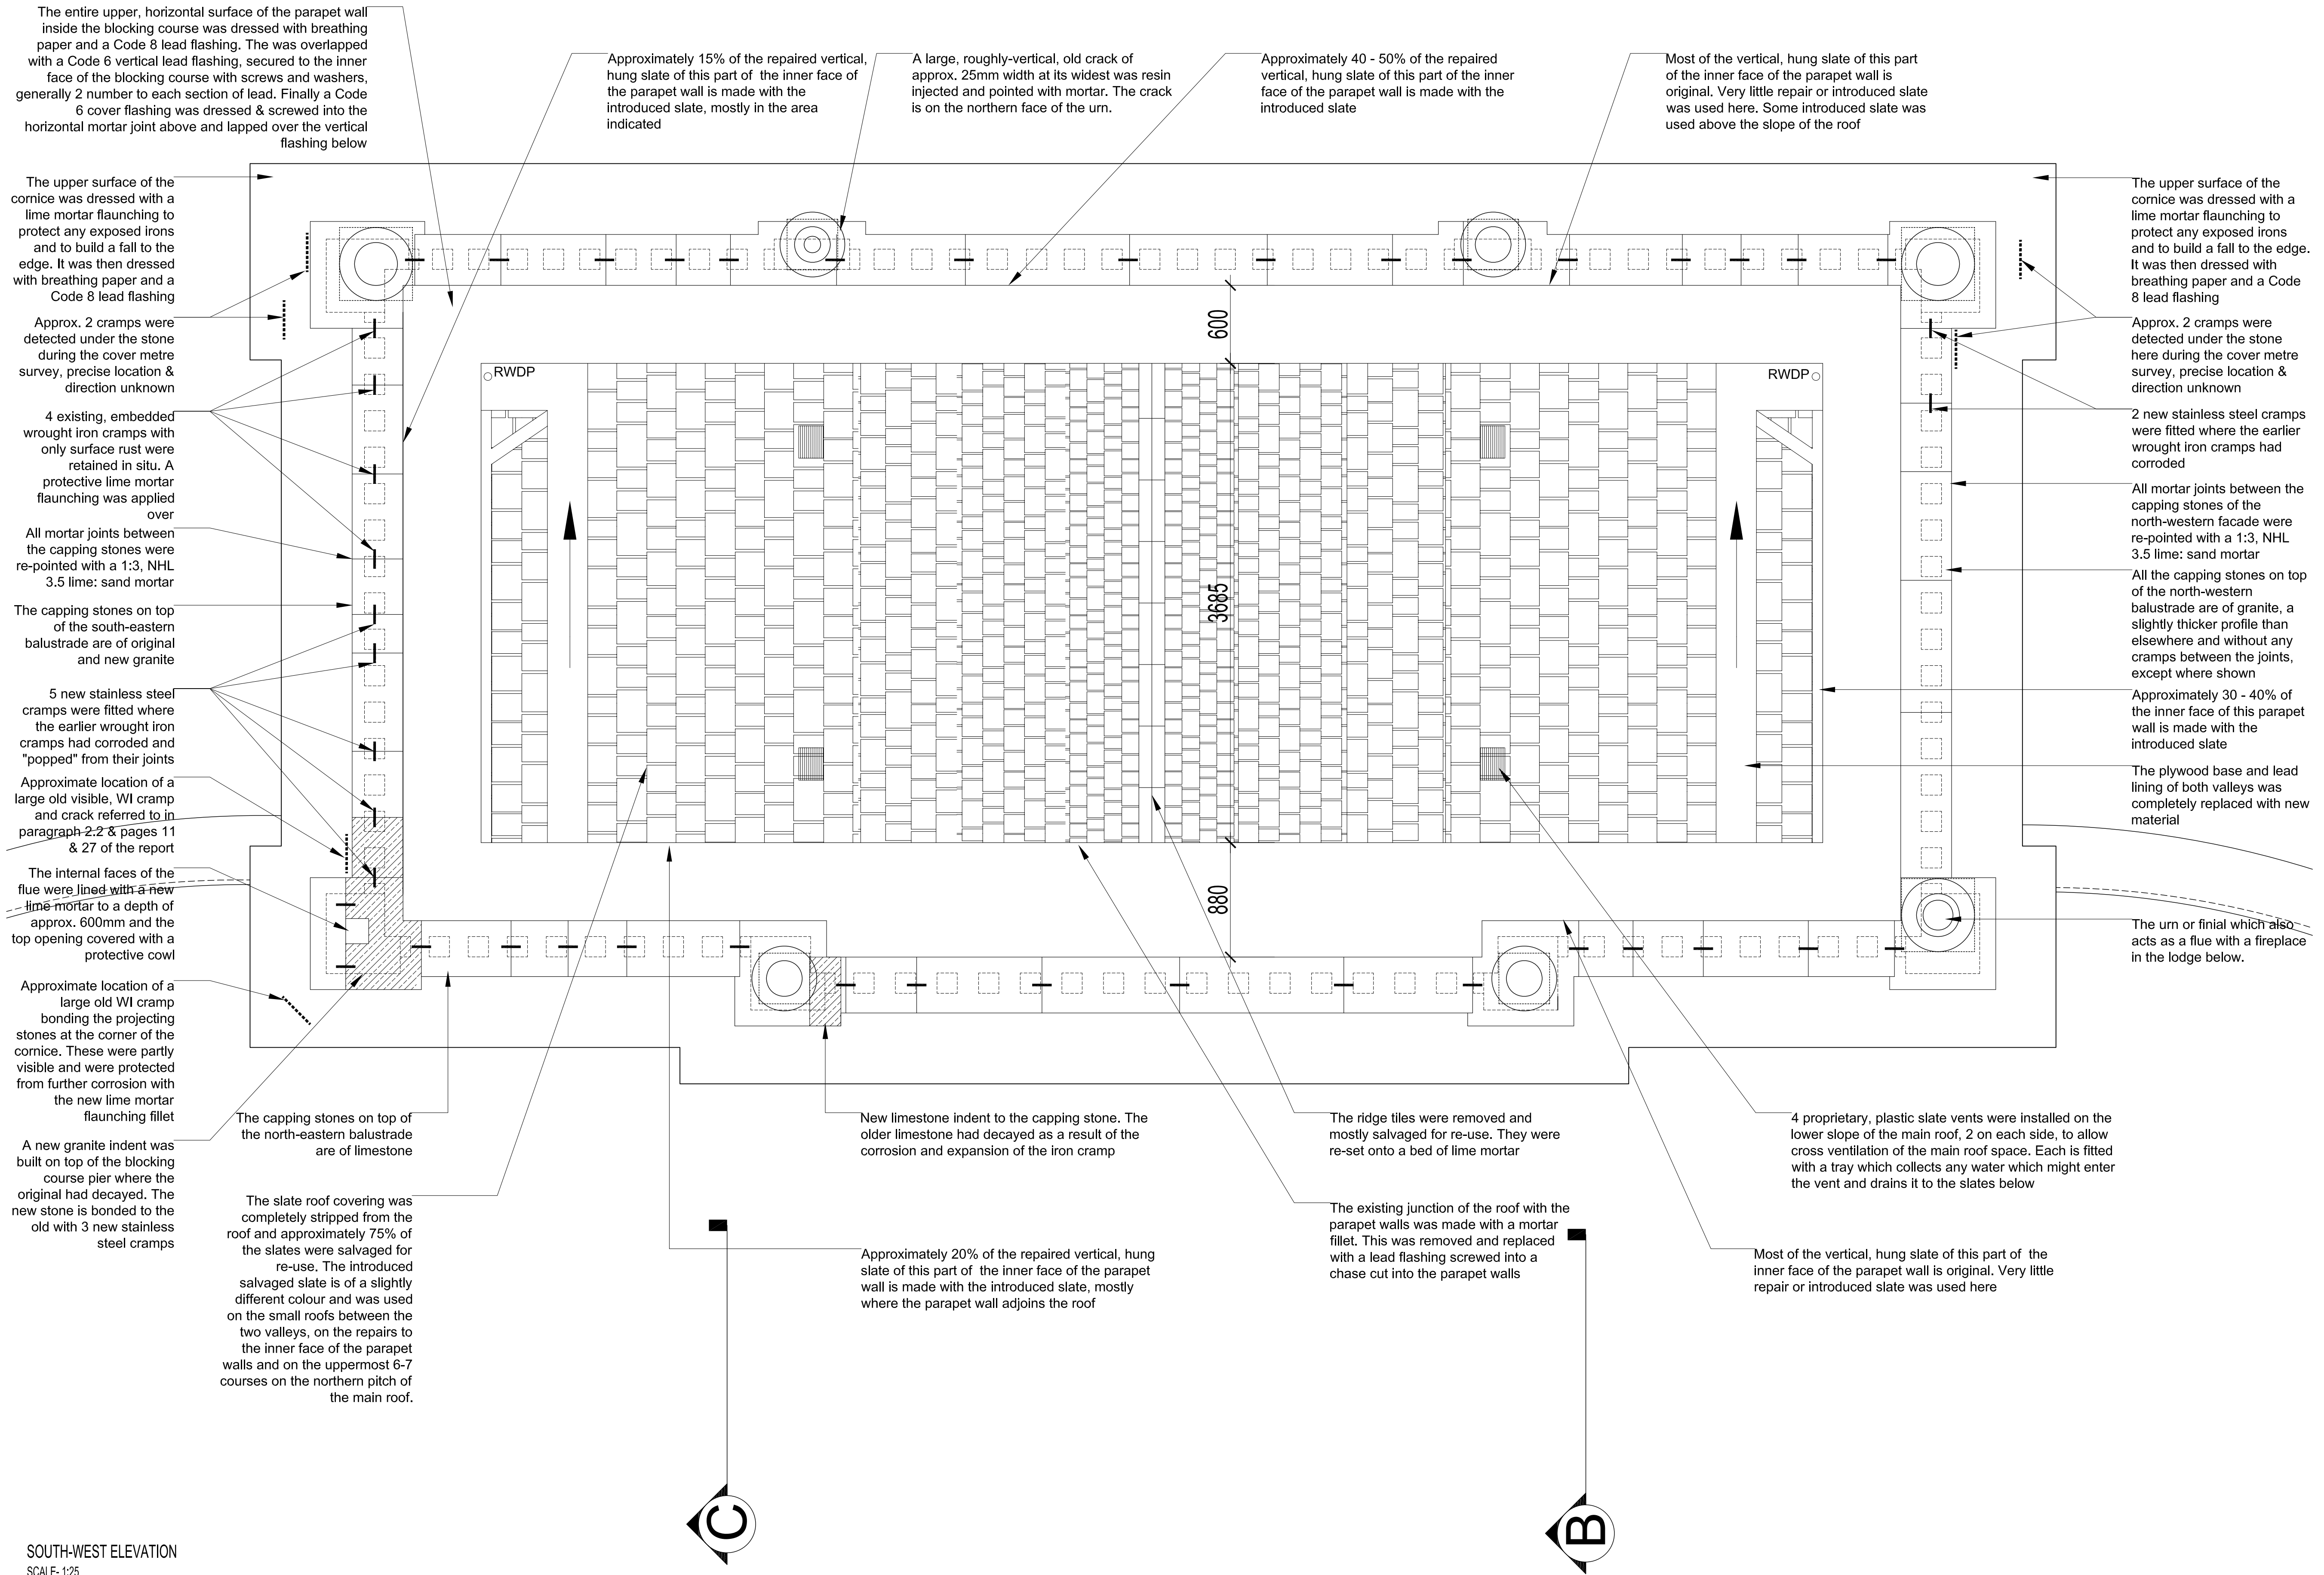

SOUTH-WEST ELEVATION
 SCALE: 1:25

NO.	DATE	REVISION


 Comhairle Contae
 Átha Cliath Theas
 South Dublin County Council
 ARCHITECTS' DEPARTMENT
 COUNTY HALL, TALLAGHT, DUBLIN 24
 TEL: 01-4149000, FAX: 01-4149209
 COUNTY ARCHITECT
 EDDIE CONROY, E.Arch., R.S.Arch., R.I.A.A.

CLIENT:

PROJECT TITLE:
 ESSENTIAL REPAIRS & CONSERVATION OF THE
 ROMAN ARCH,
 DODDER PARK ROAD,
 RATHFARNHAM,
 DUBLIN
 PROJECT STAGE: POST SUBSTANTIAL COMPLETION

DRAWING TITLE:
 AS-BUILT DRAWINGS
 ROOF PLAN

SENIOR ARCHITECT: PATRICK DE ROE

PROJECT ARCHITECT: FEARGAL Ó SULLLEIGHÁIN

DRAWN: SS & FOS	CHECKED:
SCALE: 1:25 (A1 420x594) 1:50 (A3 420x594)	DATE: SEP 2010

DRAWING NUMBER: 2009-008-I-11 REV: