



**NOTES:-**  
 1. USE FIGURED DIMENSIONS ONLY - DO NOT SCALE  
 2. ALL DRAWINGS TO BE READ IN CONJUNCTION WITH THE SPECIFICATION

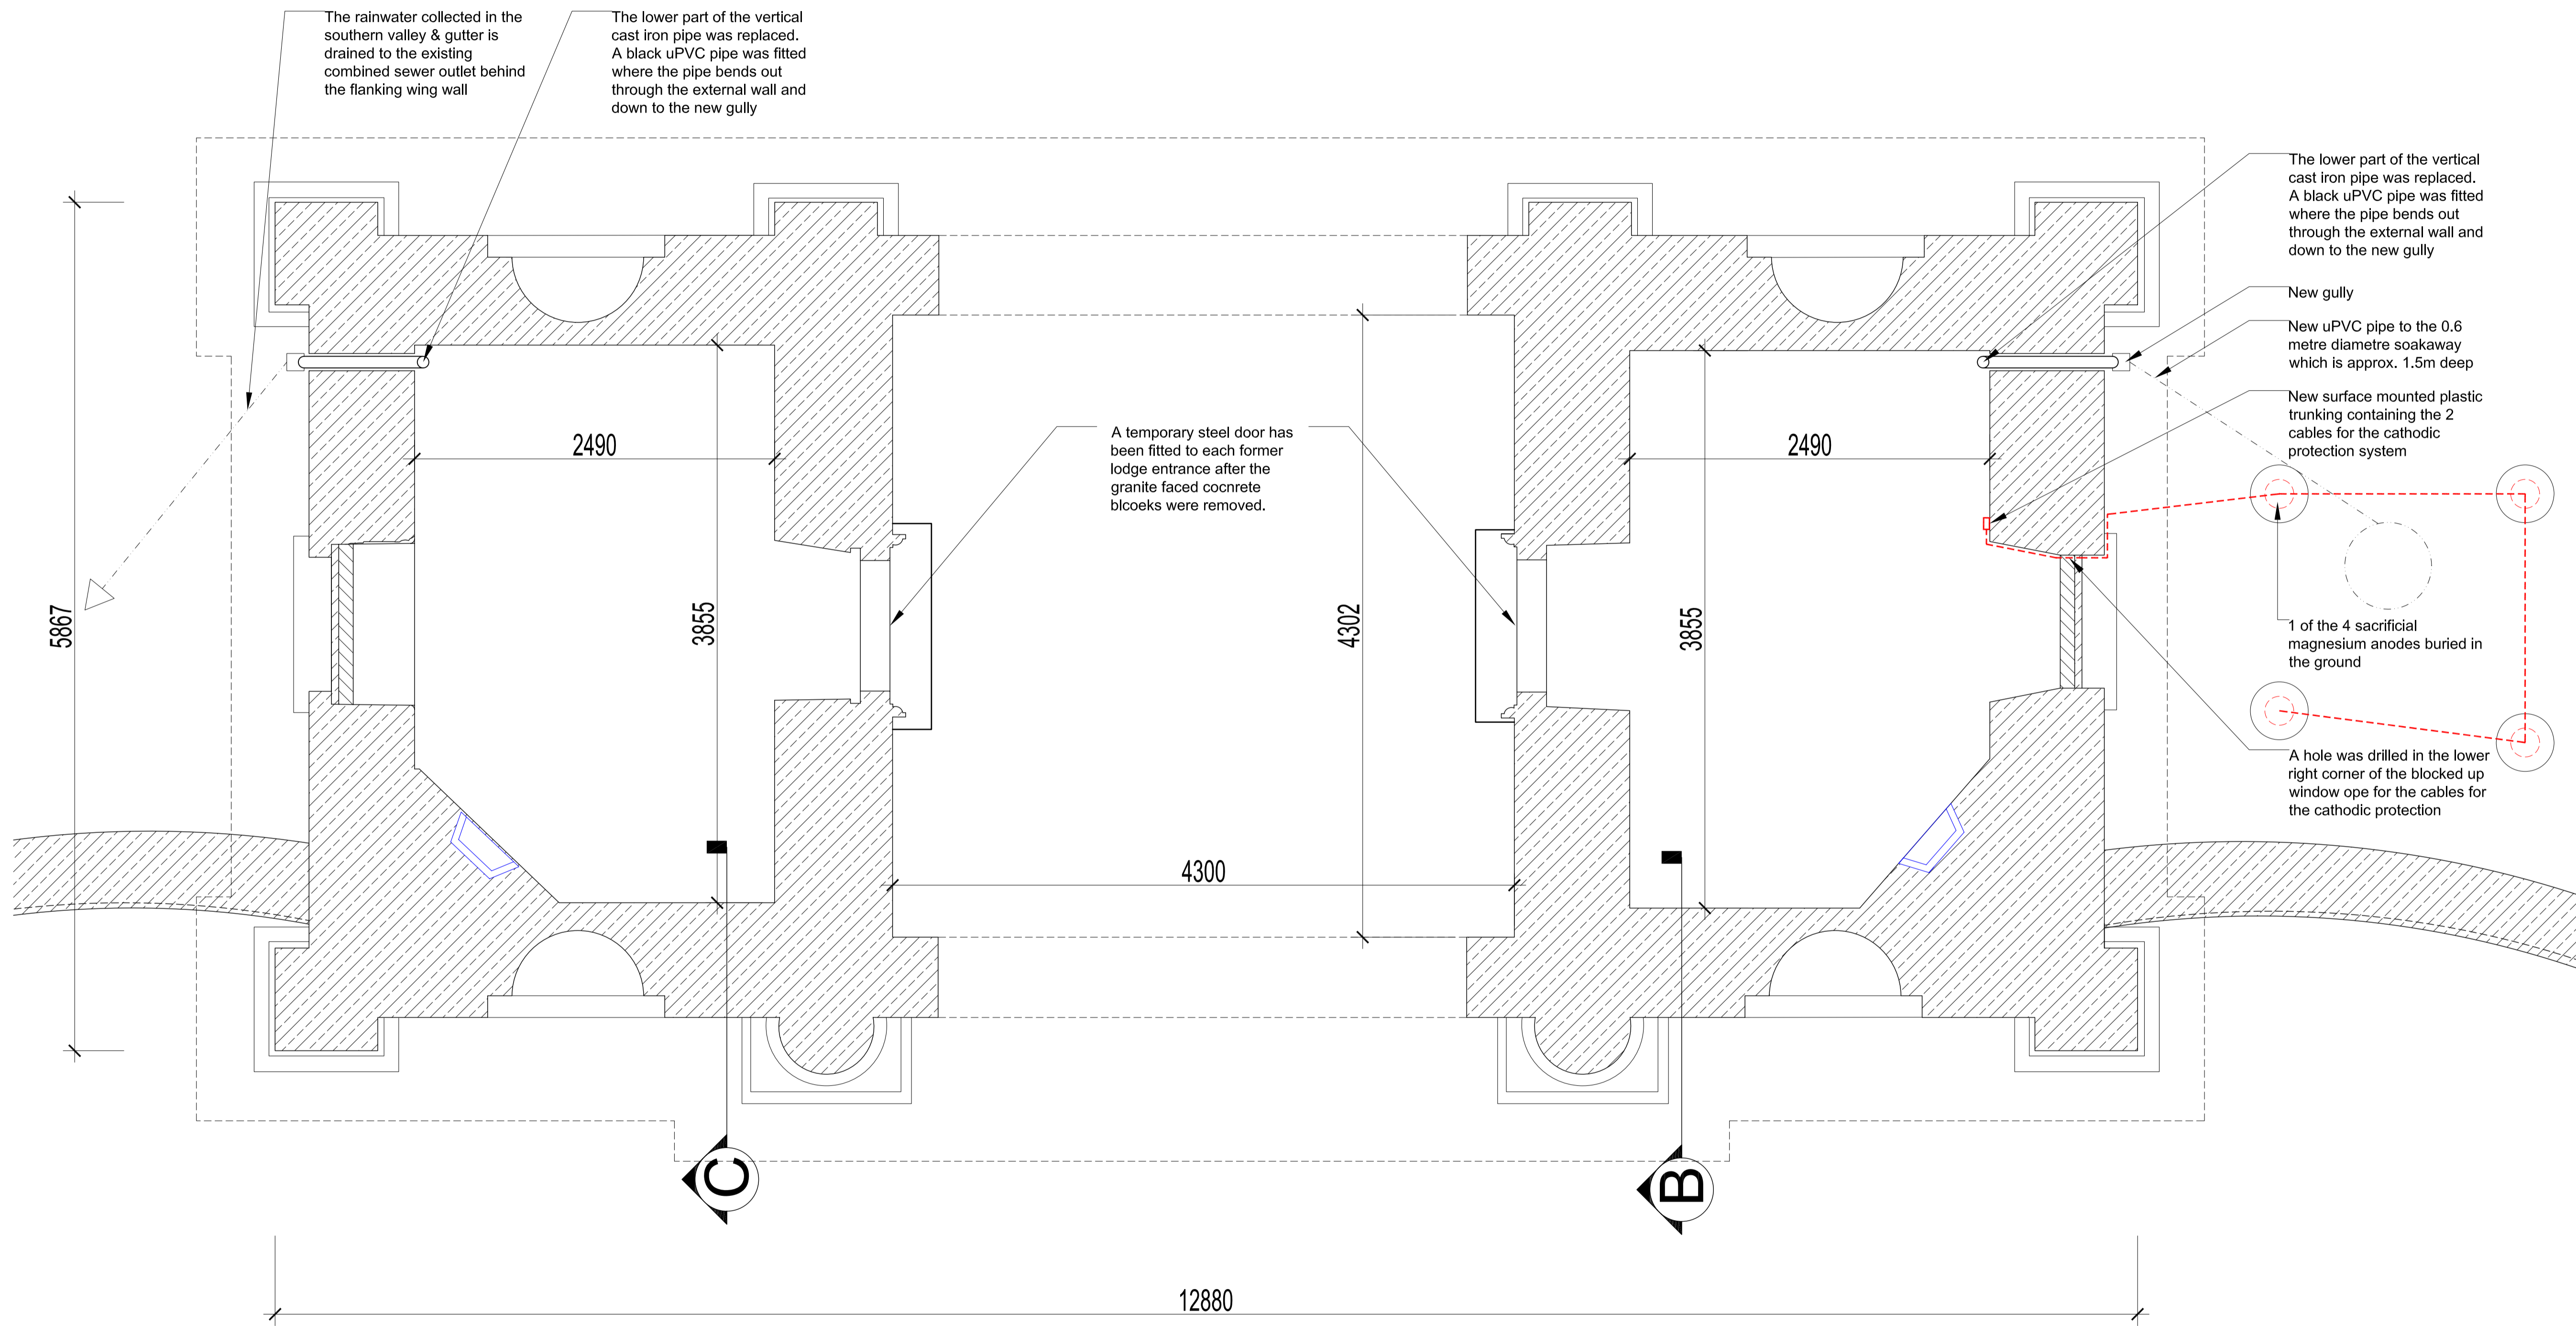

SOUTH-WEST ELEVATION  
 SCALE: 1:25

No.	DATE	REVISION

  
**Comhairle Contae Atha Cliath Theas**  
**South Dublin County Council**  
 ARCHITECTS' DEPARTMENT  
 COUNTY HALL, TALLAGHT, DUBLIN 24  
 TEL: 01-4146000, FAX: 01-4146209  
 COUNTY ARCHITECT  
 EDDIE CONROY, E.Arch., R.S.Arch., R.I.A.I.

CLIENT:

PROJECT TITLE:  
 ESSENTIAL REPAIRS & CONSERVATION OF THE  
 ROMAN ARCH,  
 DODDER PARK ROAD,  
 RATHFARNHAM,  
 DUBLIN  
 PROJECT STAGE: POST SUBSTANTIAL COMPLETION

DRAWING TITLE:  
 AS-BUILT DRAWINGS  
 GROUND FLOOR PLAN

SENIOR ARCHITECT: PATRICK DE ROE

PROJECT ARCHITECT: FEARGAL O SULLIVAN

DRAWN: SS & FOS	CHECKED:
-----------------	----------

SCALE: 1:25 (A1 610x 915)	DATE: SEP 2010
1:50 (A3 420x 594)	

DRAWING NUMBER:	2009-008-I-10	REV:
-----------------	---------------	------