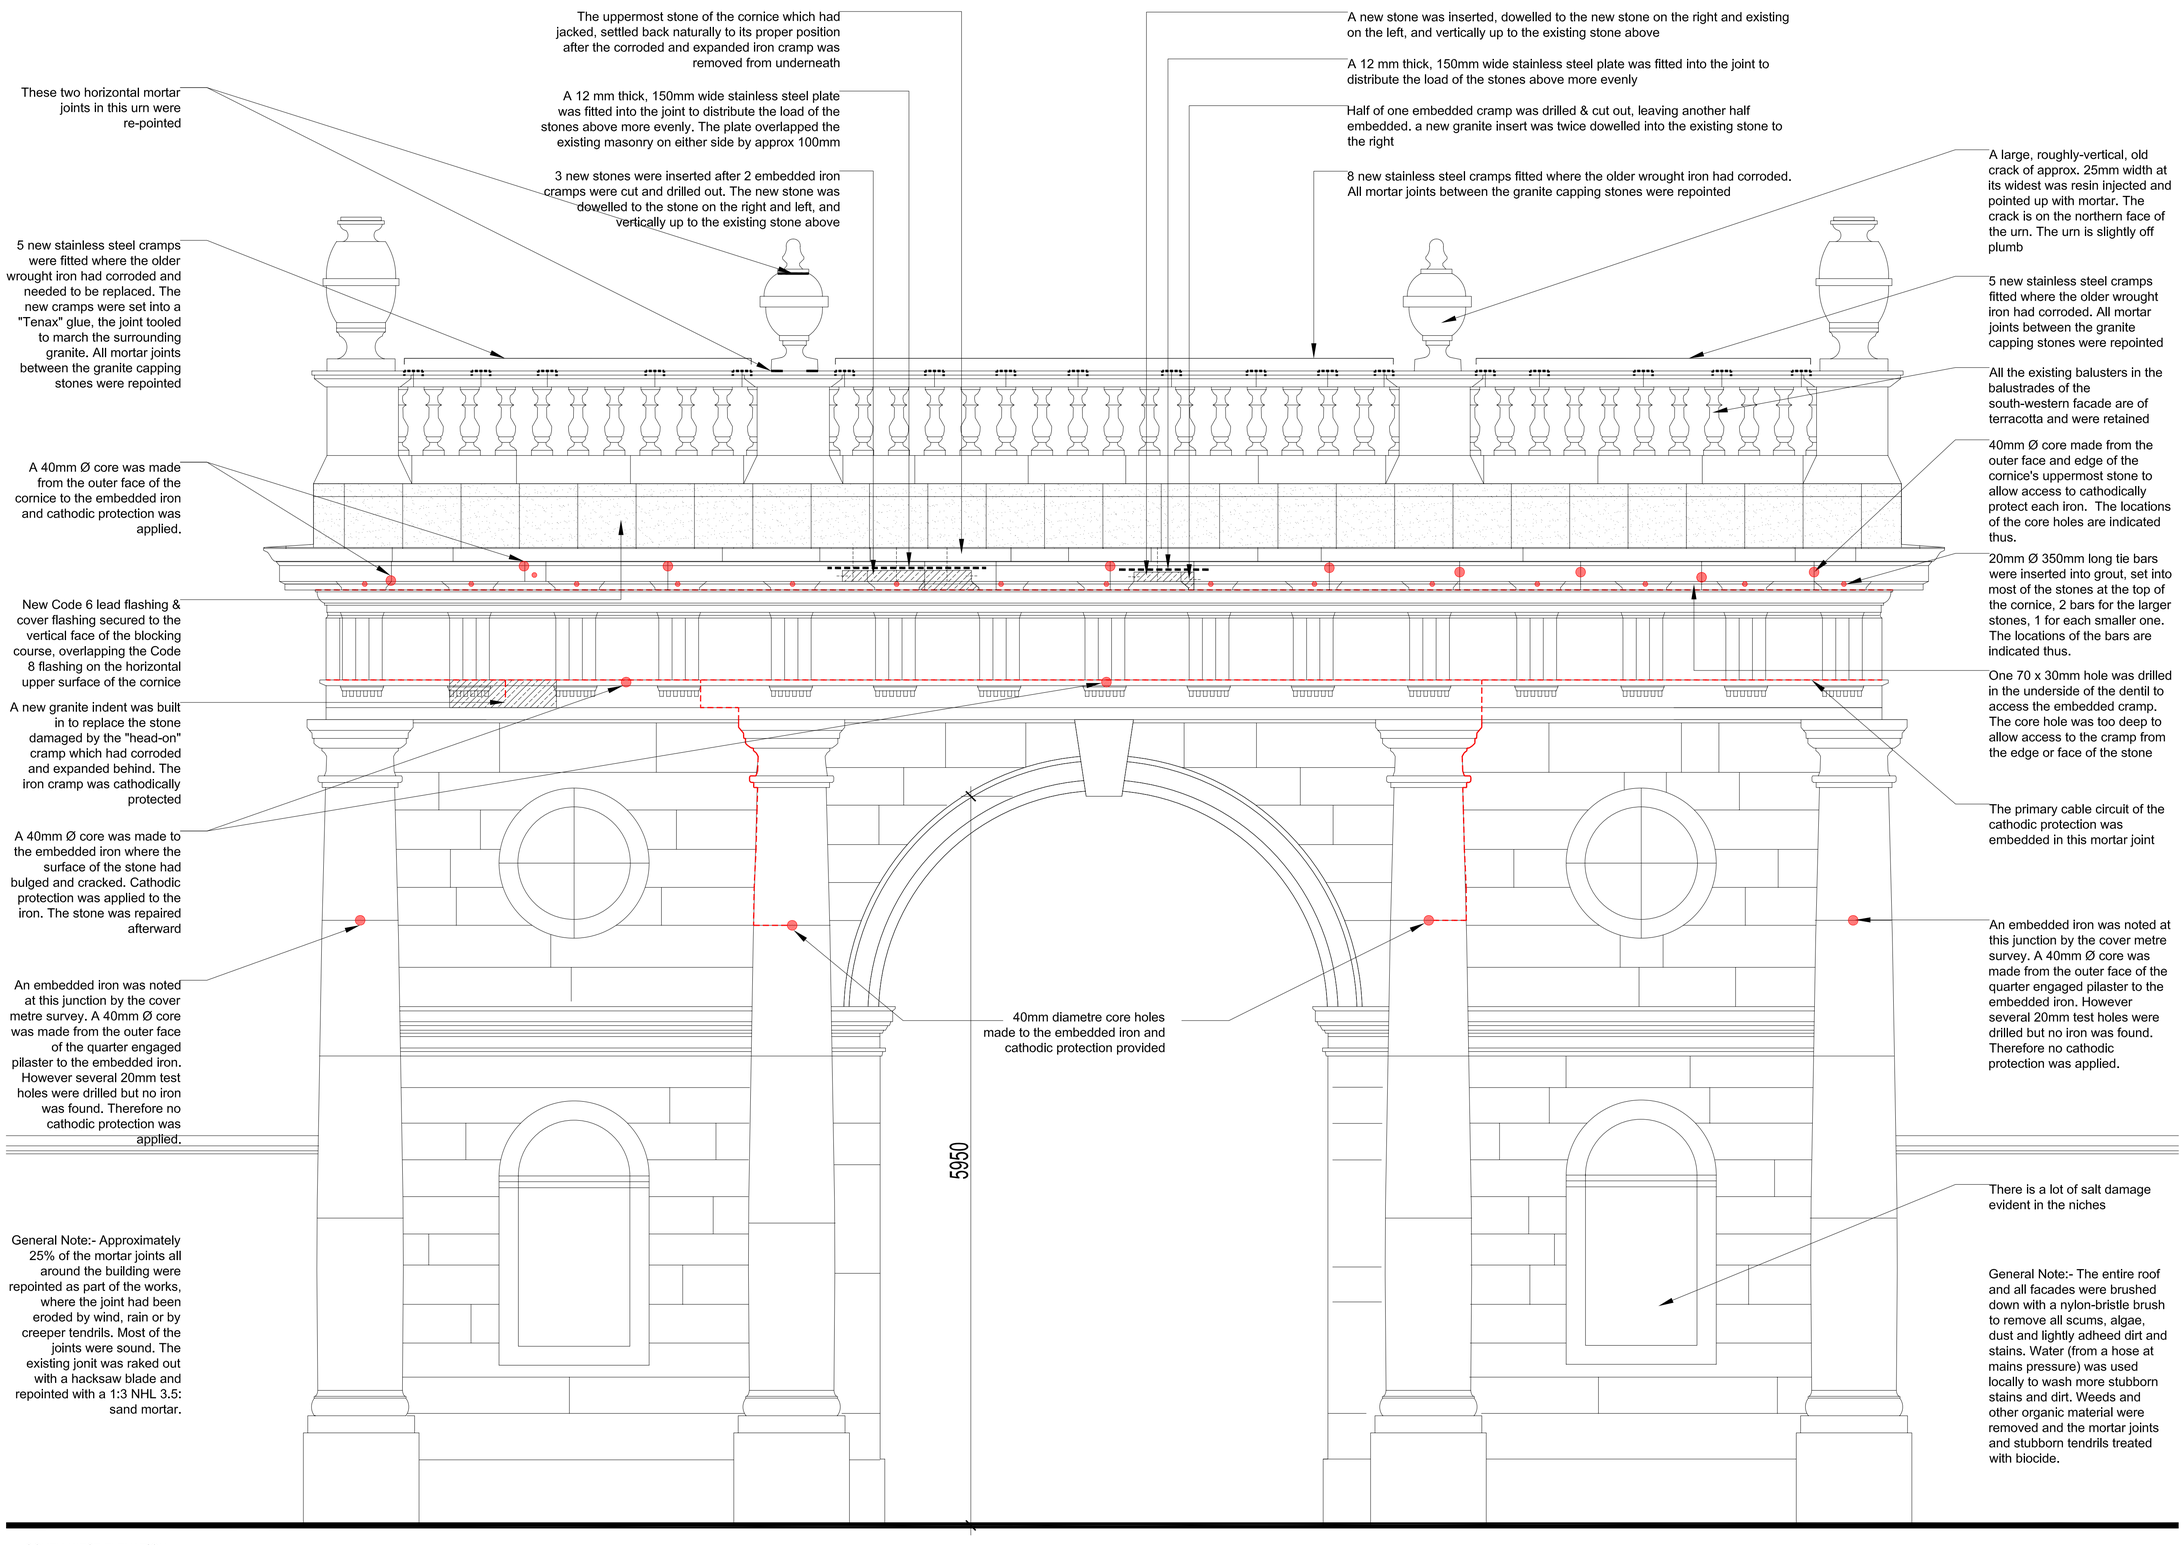

SOUTH-WEST ELEVATION

SCALE- 1:25

NOTES:-

1. USE FIGURED DIMENSIONS ONLY - DO NOT SCALE
2. ALL DRAWINGS TO BE READ IN CONJUNCTION WITH THE SPECIFICATION

No.	DATE	REVISION

Comhairle Contae
Átha Cliath Theas
South Dublin County Council
ARCHITECTS' DEPARTMENT
COUNTY HALL, TALLAGHT, DUBLIN 24
TEL: 01-4149000, FAX: 01-4149209
COUNTY ARCHITECT
EDDIE CONROY, B.Arch., M.Sc.Arch, FRAI

CLIENT:

PROJECT TITLE:
ESSENTIAL REPAIRS & CONSERVATION OF THE ROMAN ARCH,
DODDER PARK ROAD,
RATHFARNHAM,
DUBLIN

PROJECT STAGE: POST SUBSTANTIAL COMPLETION

DRAWING TITLE:
AS-BUILT DRAWINGS
SOUTH-WEST ELEVATION

SENIOR ARCHITECT: PATRICK DE ROE

PROJECT ARCHITECT: FEARGAL Ó SÚILLEABHÁIN

DRAWN: SS & FOS	CHECKED:
SCALE:- 1:25 (A1 size page) 1:50 (A3 size page)	DATE: SEP 2010

DRAWING NUMBER: 2009-008-I-25

REV: